

PROJECT TITLE: DOMINION PARK MASTER PLAN-PHASE 1	ADD. NO: 1
TENDER NO: 2022-081202T	DATE: November 10 th , 2022
PAGE 1 of 5 (Including Confirmation Sheet)	

Make the following modifications to the above project. Include in the amount of the Tender, any additions to or deductions from the cost of the work by reason of these instructions.

Sign and attach this Addendum to the Tender documents and submit with your Tender. Failure to do so may result in the rejection of your Tender.

Please note the following questions and answers.

- Q1. In roof section 07 41 00 item 2.2.1. the acceptable product is SuperVic profile by Vicwest this product is not recommended roof slopes under 4/12 and the roof slope on your building is 2/12.
- A1. Upon discussion with the supplier, SuperVic profile would be fine on this slope but suggests a "High Temp Membrane" underlay as specified.
- Q2. Drawings indicators for 3D painted sidewalk and change room containers appear to be switched on drawings L2 and are referencing wrong details.
- A2. Upon review this is correct. Please switch the numbers on these two reference bubbles.
- Q3. With regard to the bid from are there suggest amounts for the two allowances noted in item L. The building permit one I am a bit more clear on than the Saint John Energy Equipment and Cabling amount which is a bit difficult to determine.
- A3. The contractor is to carry \$5, 200.00 for Item L-2 Saint John Energy Equipment and Cabling Allowance and \$3, 200.00 for Item L-3 Building Permit Allowance.
- Q4. What are the base requirements for the relocated shed as there is nothing indicated for what it is currently resting on or what it is to be relocated on to.
- A4. The base requirements are to be placed on patio stones on top of a base material to match existing.

SIGN AND RETURN THIS ADDENDUM WITH YOUR PROPOSAL

BY: Monic Maelluar		
Monic MacVicar, CCLP, CPPB	Contractor's Signature	
Procurement Specialist, Supply Chain Management	-	



PROJECT TITLE: DOMINION PARK MASTER PLAN-PHASE 1	ADD. NO: 1
TENDER NO: 2022-081202T	DATE: November 10 th , 2022
PAGE 2 of 5 (Including Confirmation Sheet)	

- Q5. There are no door sizes on the drawings or in the specification. Can you please provide a door schedule with sizes.
- A5. All doors are to be sized 0.844m inside opening, 0.908m outside opening and 2.13m tall.
- Q6. I do not see a section on the unit prices for the electrical trench. Where is this to be covered as it would usually be something in the civil contractors scope of work.
- A6. Include cost for this work with Item I-1 "Washroom/Canteen Building inclusive of foundation work, mechanical, electrical (including work to pole), structural, architectural detailing and signage.

TO DIVISION 3 – PARTICULAR SPECIFICATIONS

Section 32 37 00

Page 3 of 6, Add Section 2.1.3.9, "Grab Bars"

- .1 Grab Bars:
- .1 Product: Bobrick Washroom Equipment Model # B-5806x24

Quantity: Three (3)

Section 32 37 00

Page 3 of 6, Add Section 2.1.3.10, "Accessible Seat"

- .1 Accessible Seat:
- .1 Product: Bobrick Washroom Equipment Model # B-5192

Quantity: Three (3)

Section 09 70 51

Page 2 of 3, Add Section 2.1.5, "Approved Equals"

.1 Approved Equals:

SIGN AND RETURN THIS ADDENDUM WITH YOUR PROPOSAL

BY: Monic Maelluar	
Monic MacVicar, CCLP, CPPB	Contractor's Signature
Procurement Specialist, Supply Chain Management	



PROJECT TITLE: DOMINION PARK MASTER PLAN-PHASE 1	ADD. NO: 1
TENDER NO: 2022-081202T	DATE: November 10 th , 2022
PAGE 3 of 5 (Including Confirmation Sheet)	

- .1 Product: Sikafloor Quartzite Broadcast System
 Section 09 91 99, Page 3 of 5, Add Section 2.1.9, "Seacan Painting"
- .1 Undercoat entire seacan, interior and exterior: Amerlock 2 by PPG, or approved equal.
- .2 Top coat entire seacan interior and exterior: Acrylic paint, or approved equal. See drawings for pattern.
- .1 Colour 1: RAL 2003 PASTEL ORANGE
- .2 Colour 2: RAL 2004 PURE ORANGE
- .3 Colour 3: RAL 2001 RED ORANGE
- .4 Colour 4: RAL 9010 PURE WHITE

Please add the following change to the drawing.

On Sheet L8 "CHANGING ROOM", replace the detail 1/L8 "CHANGE ROOM SECTION A-A" with, attached sketch ASK1 "CHANGE ROOM SECTION A-A".

On Sheet L8 "CHANGING ROOM", replace the detail 3/L8 "CHANGE ROOM SECTION D-D" with, attached sketch ASK2 "CHANGE ROOM SECTION D-D".

On Sheet M-1 "VENTILATION AND PLUMBING" add Zurn to the "PLUMBING FIXTURE SCHEDULE" as an approved equal.

On Sheet M-1 "VENTILATION AND PLUMBING" detail 3/M-1 "FLOOR PLAN – VENTIALTION" add note "ALL DUCTWORK LOCATED IN ATTIC TO BE C/W 1 $\frac{1}{2}$ " FIBERGLASS BLANKET INSULATION WITH FOIL FACE"

On Sheet E2 "ELECTRICAL SCHEDULES AND DETAILS" detail showing electrical trenching, add a fourth line of conduit for future communications with note reading "1 – FUTURE, TO RUN FROM POLE TO BUILDING"

SIGN AND RETURN THIS ADDENDUM WITH YOUR PROPOSAL

BY: Monic Maelluar		
Monic MacVicar, CCLP, CPPB	Contractor's Signature	
Procurement Specialist, Supply Chain Management	_	



PROJECT TITLE: DOMINION PARK MASTER PLAN-PHASE 1	ADD. NO: 1
TENDER NO: 2022-081202T	DATE: November 10 th , 2022
PAGE 4 of 5 (Including Confirmation Sheet)	

CONFIRMATION - RECEIPT OF ADDENDUM

Upon receipt of this document, fax this page to (506) 658-4742 to confirm receipt of this addendum.

CONTRACTOR'S NAME:		
ADDRESS:		
PHONE:	FAX:	
RECEIVER NAME (PRINT)		
RECEIVER SIGNATURE:		

SIGN AND RETURN THIS ADDENDUM WITH YOUR PROPOSAL


BY: Monic Maelluar	
Monic MacVicar, CCLP, CPPB	Contractor's Signature

Procurement Specialist, Supply Chain Management

ASK1

2022-081202T - DOMINION PARK MASTER PLAN - PHASE 1 TITLE: CHANGE ROOM SECTION A-A DATE: NOVEMBER 2, 2022

DRAWN BY: MB SCALE: 1:50 GROUP LANDSCAPE ARCHITECTS & PARK PLANNERS

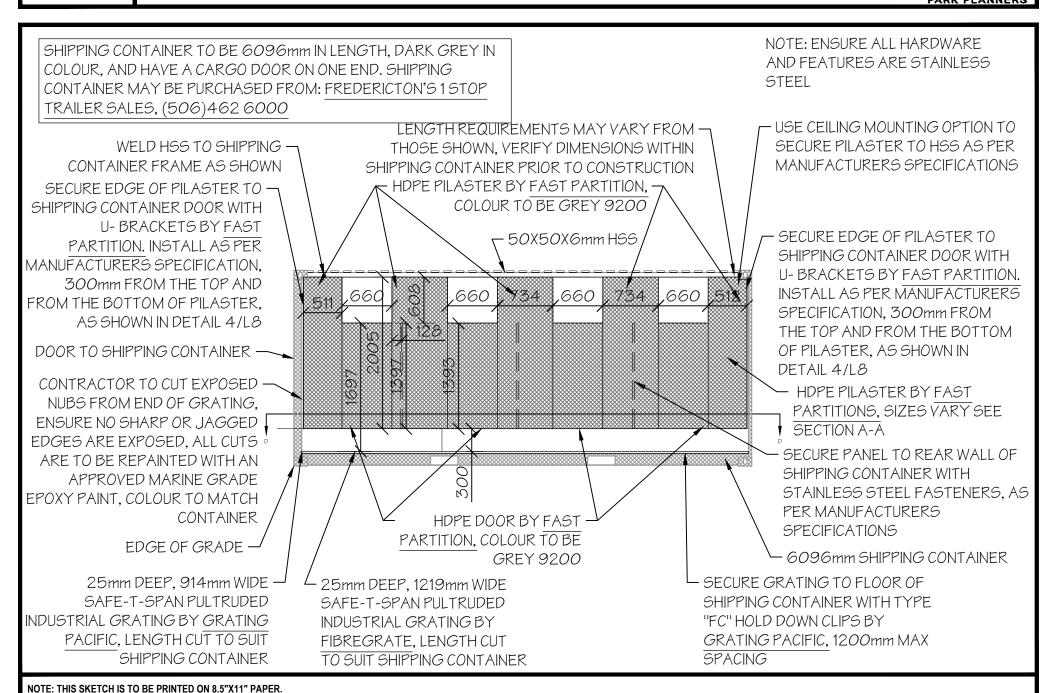


ASK2

2022-081202T - DOMINION PARK MASTER PLAN - PHASE 1 TITLE: CHANGE ROOM SECTION D-D

DATE: NOVEMBER 2, 2022

DRAWN BY: MB SCALE: 1:50 GROUP
LANDSCAPE
ARCHITECTS &
PARK PLANNERS

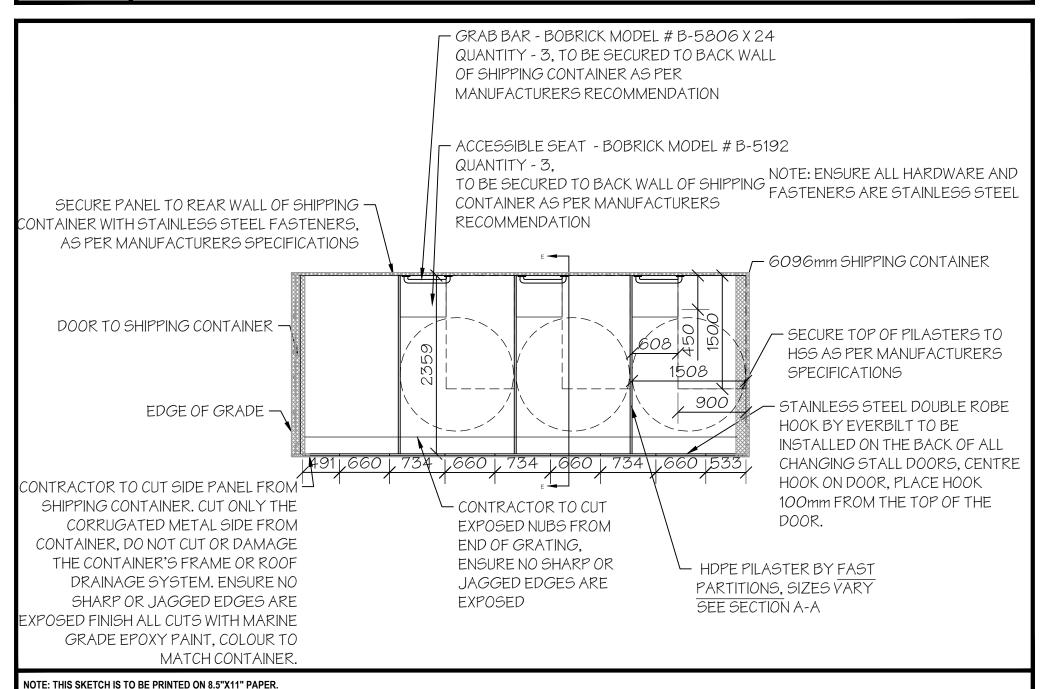

ASK3

2022-081202T - DOMINION PARK MASTER PLAN - PHASE 1

TITLE: SEACAN CHANGE ROOM PAINTING

DATE: NOVEMBER 9, 2022

DRAWN BY: NL SCALE: 1:50 GLENN GROUP LANDSCAPE ARCHITECTS & PARK PLANNERS

COLOUR SELECTIONS:


RAL9010 PURE WHITE

RAL2003

PASTEL ORANGE

RAL2004 PURE ORANGE

RAL2001 RED ORANGE

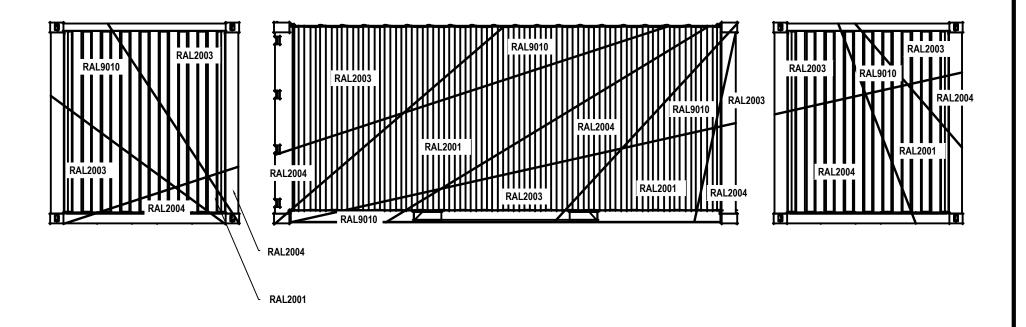

NOTE: SIGNAGE NOT SHOWN FOR CLARITY.